
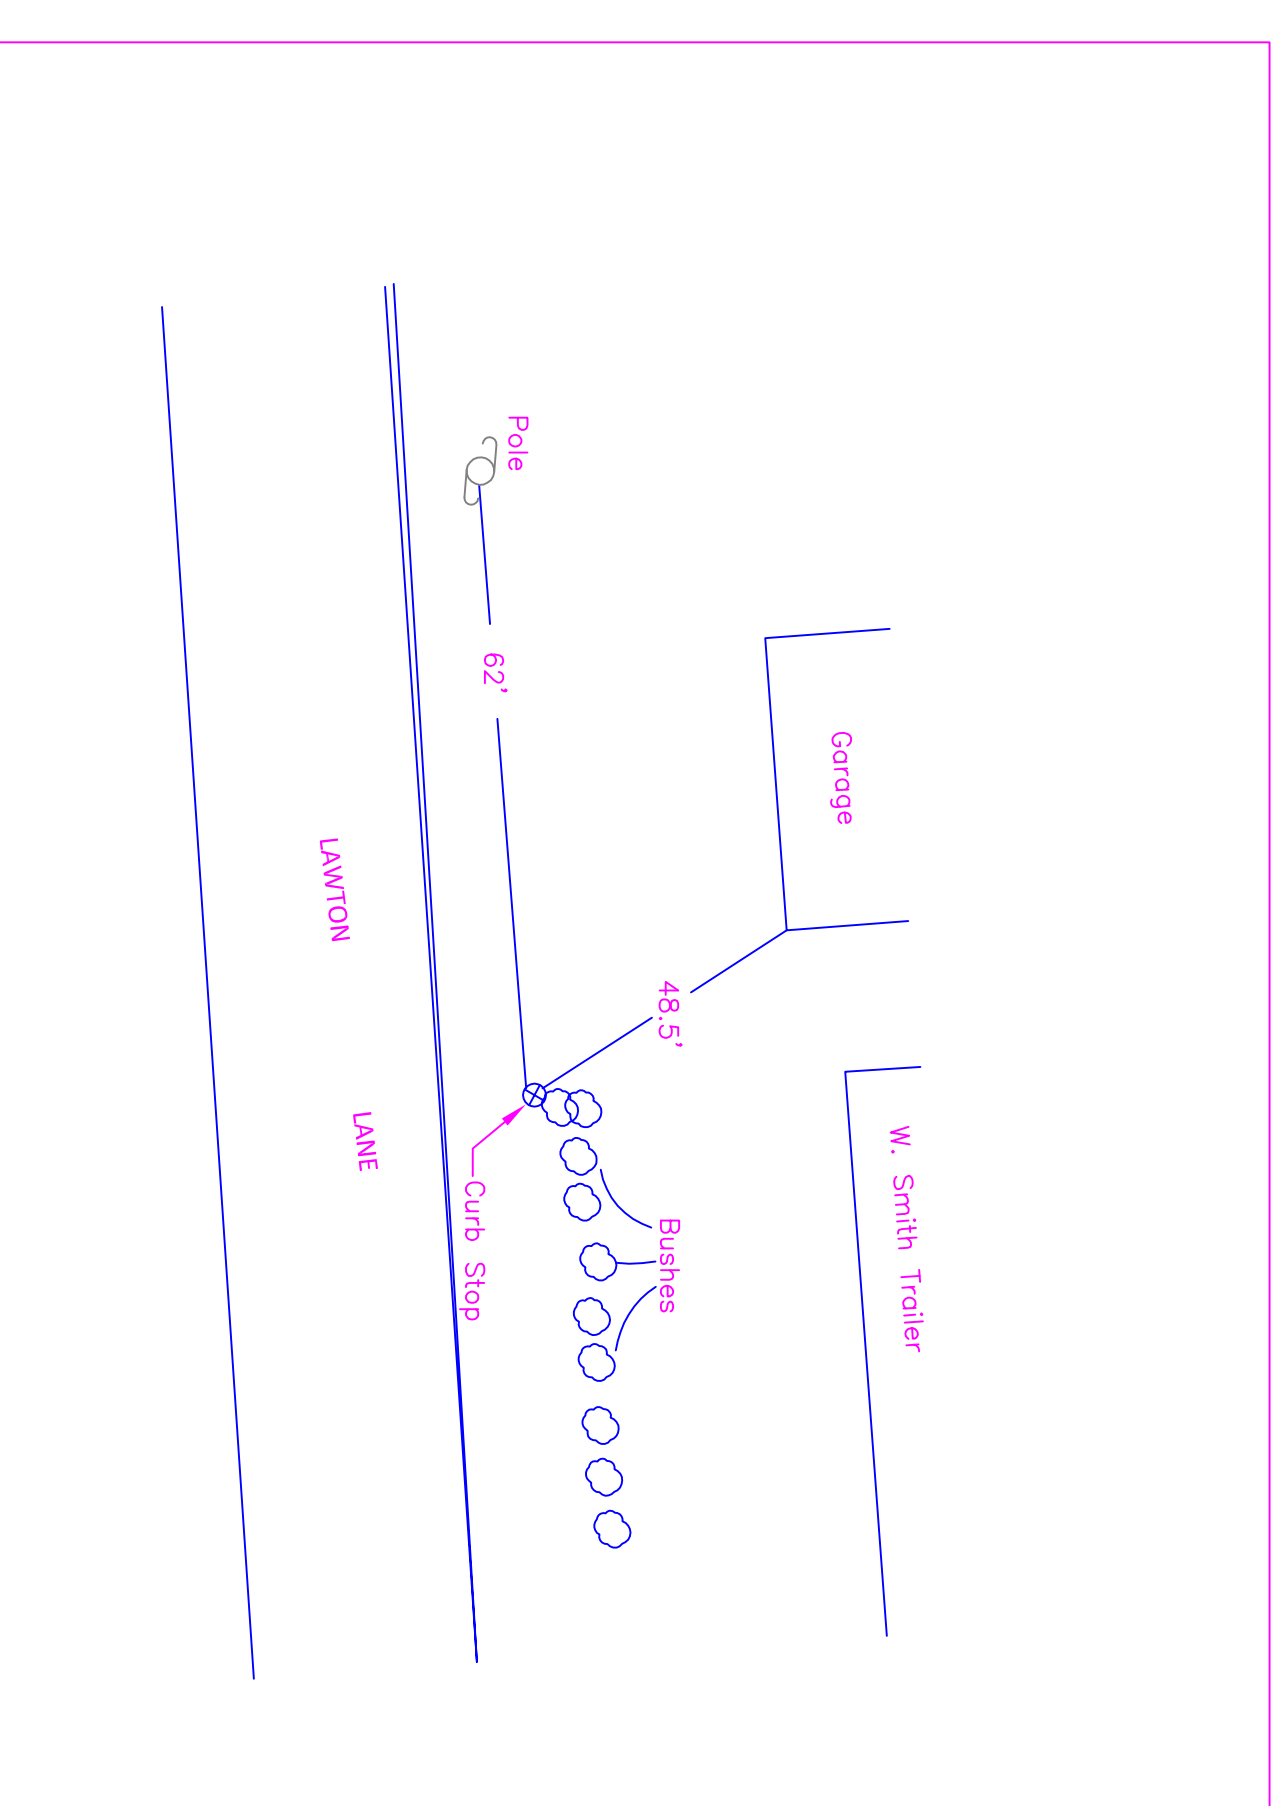
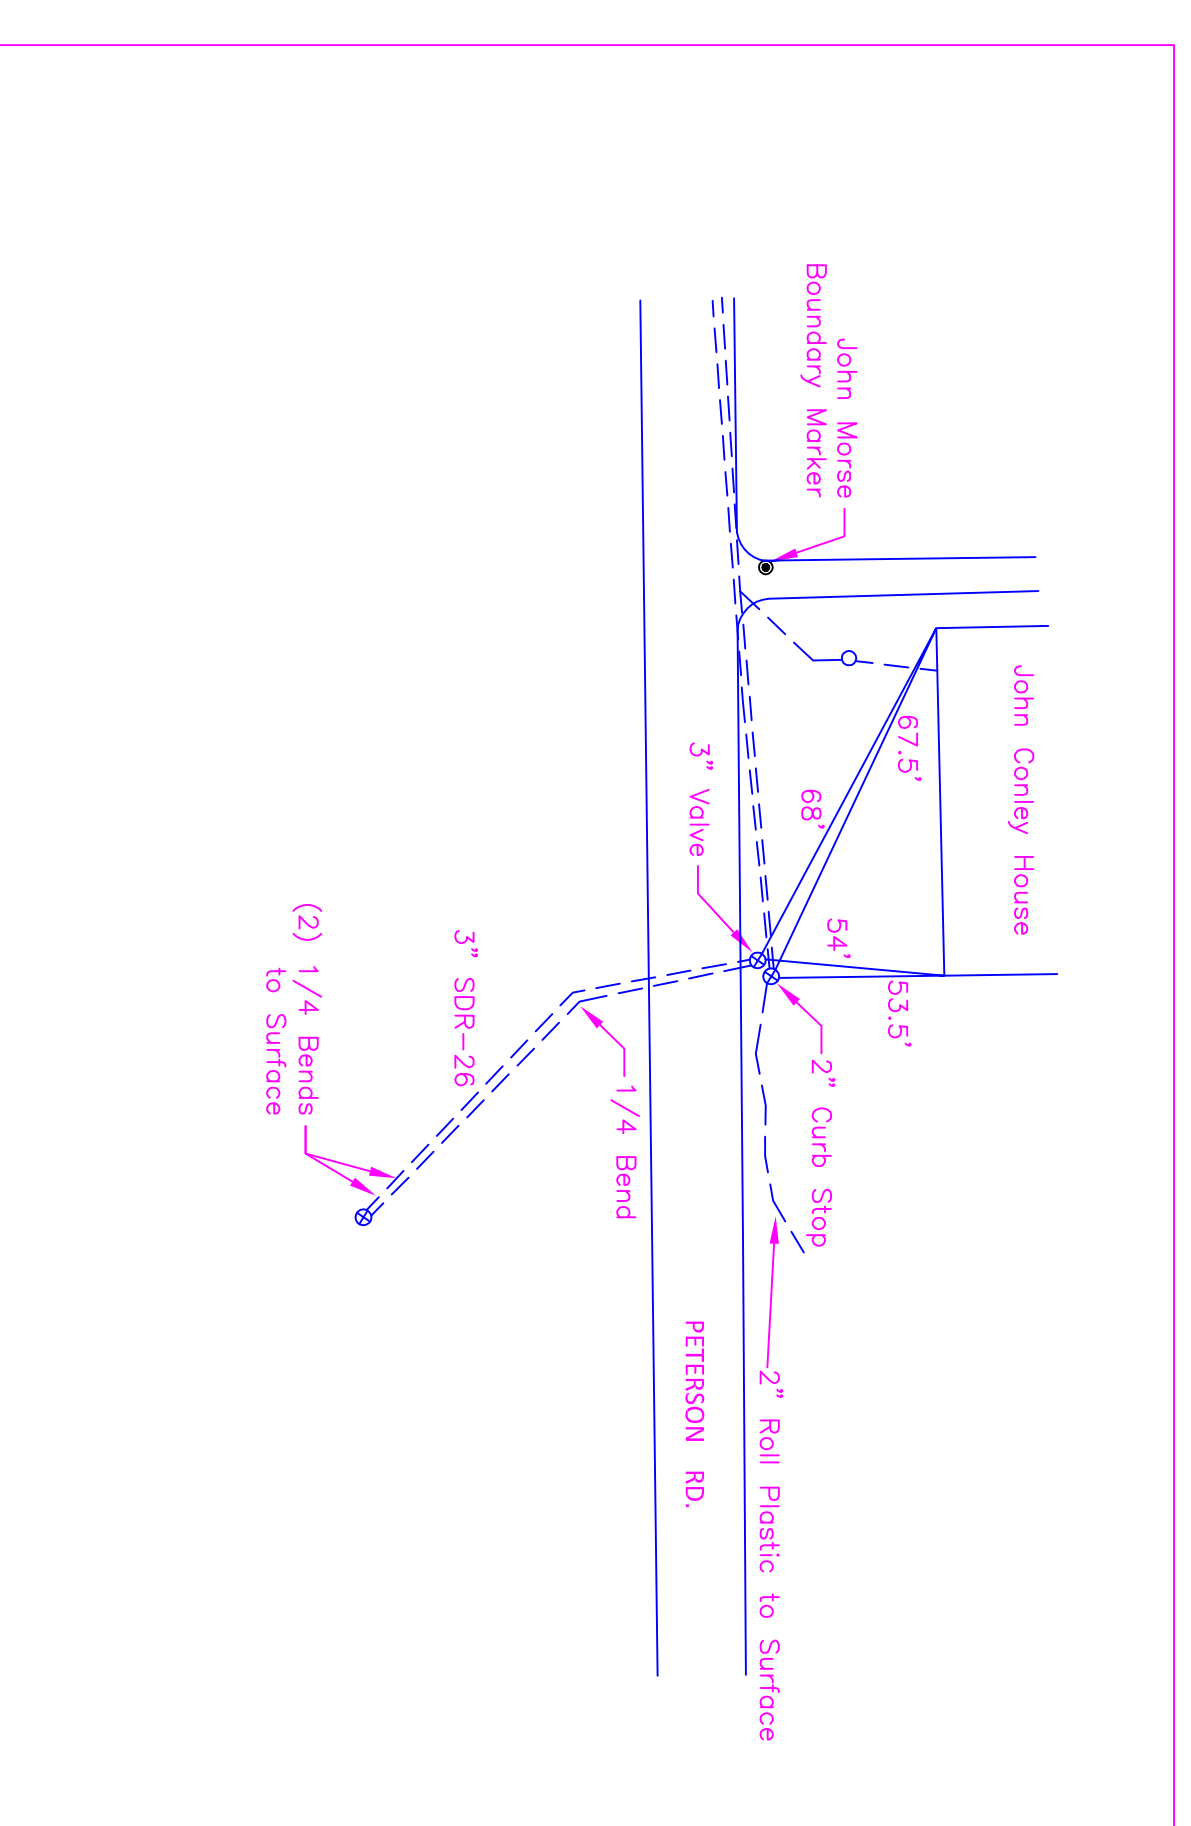
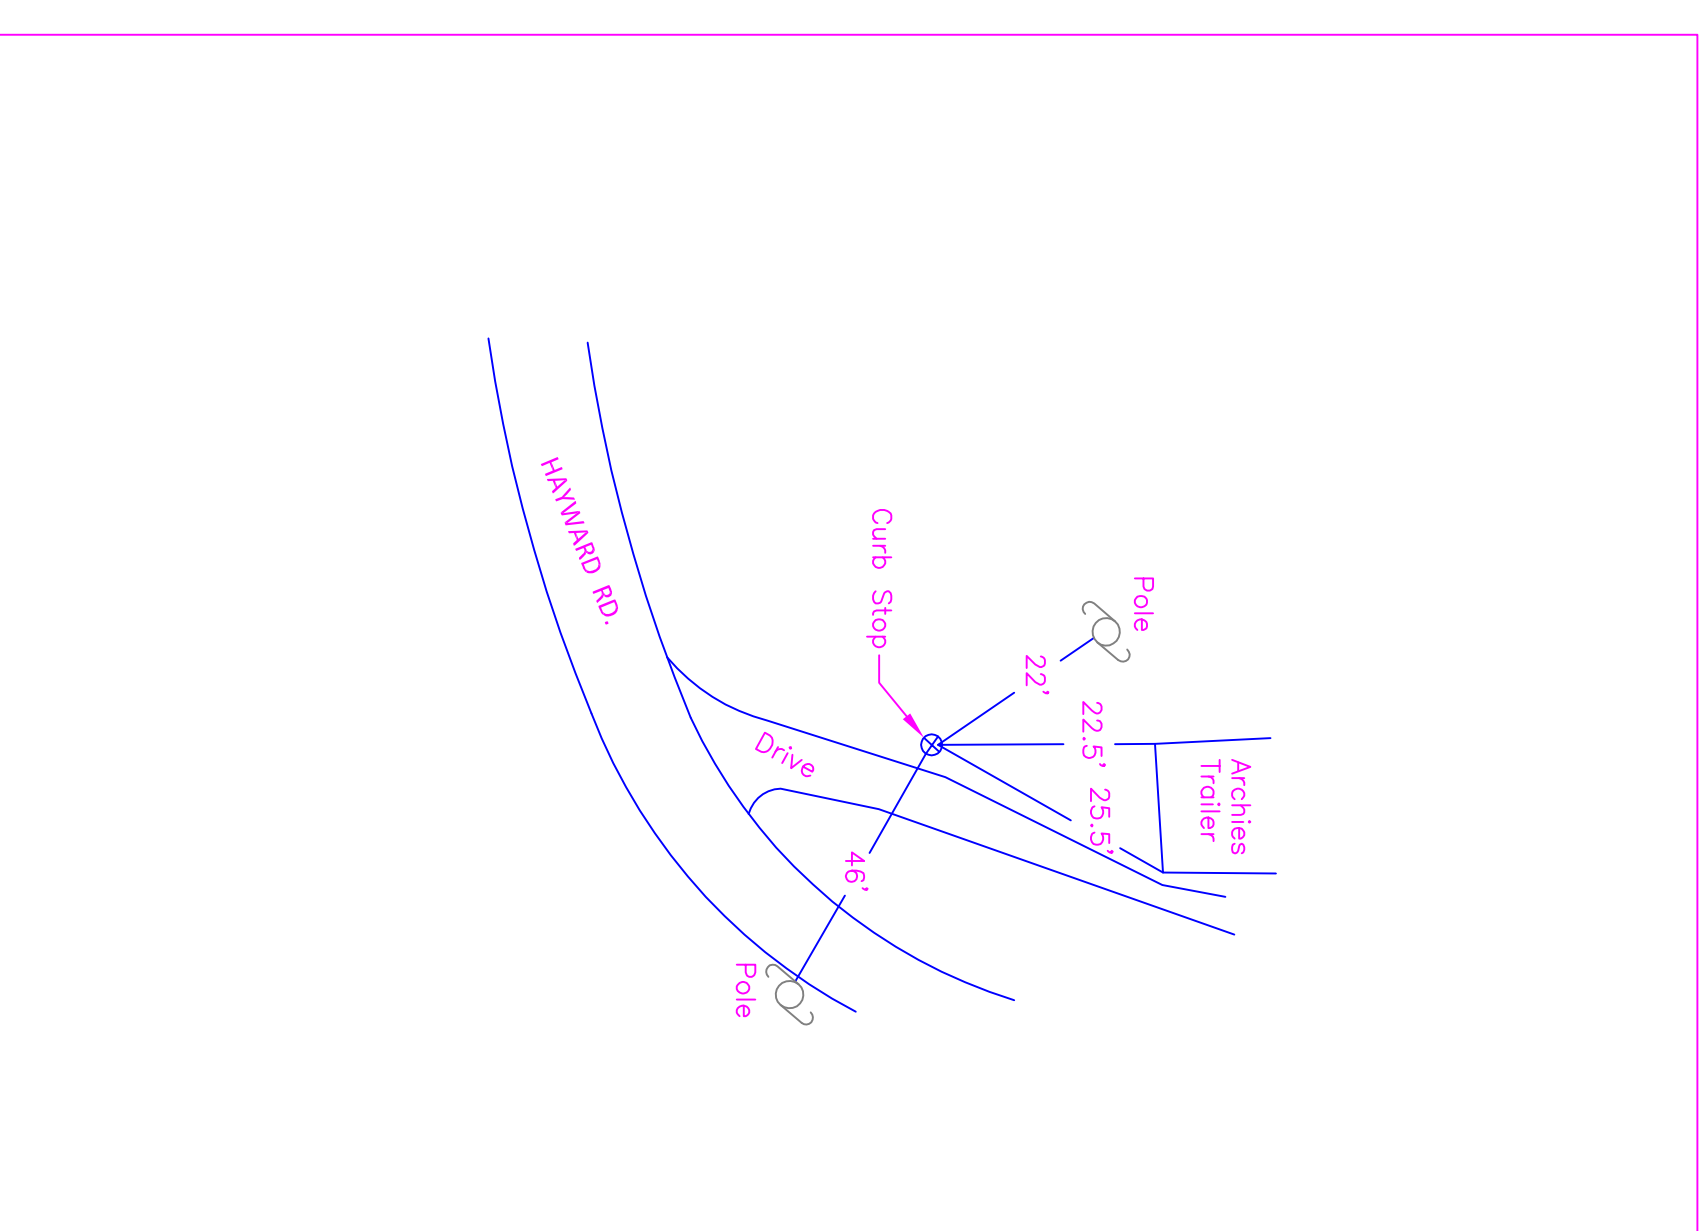
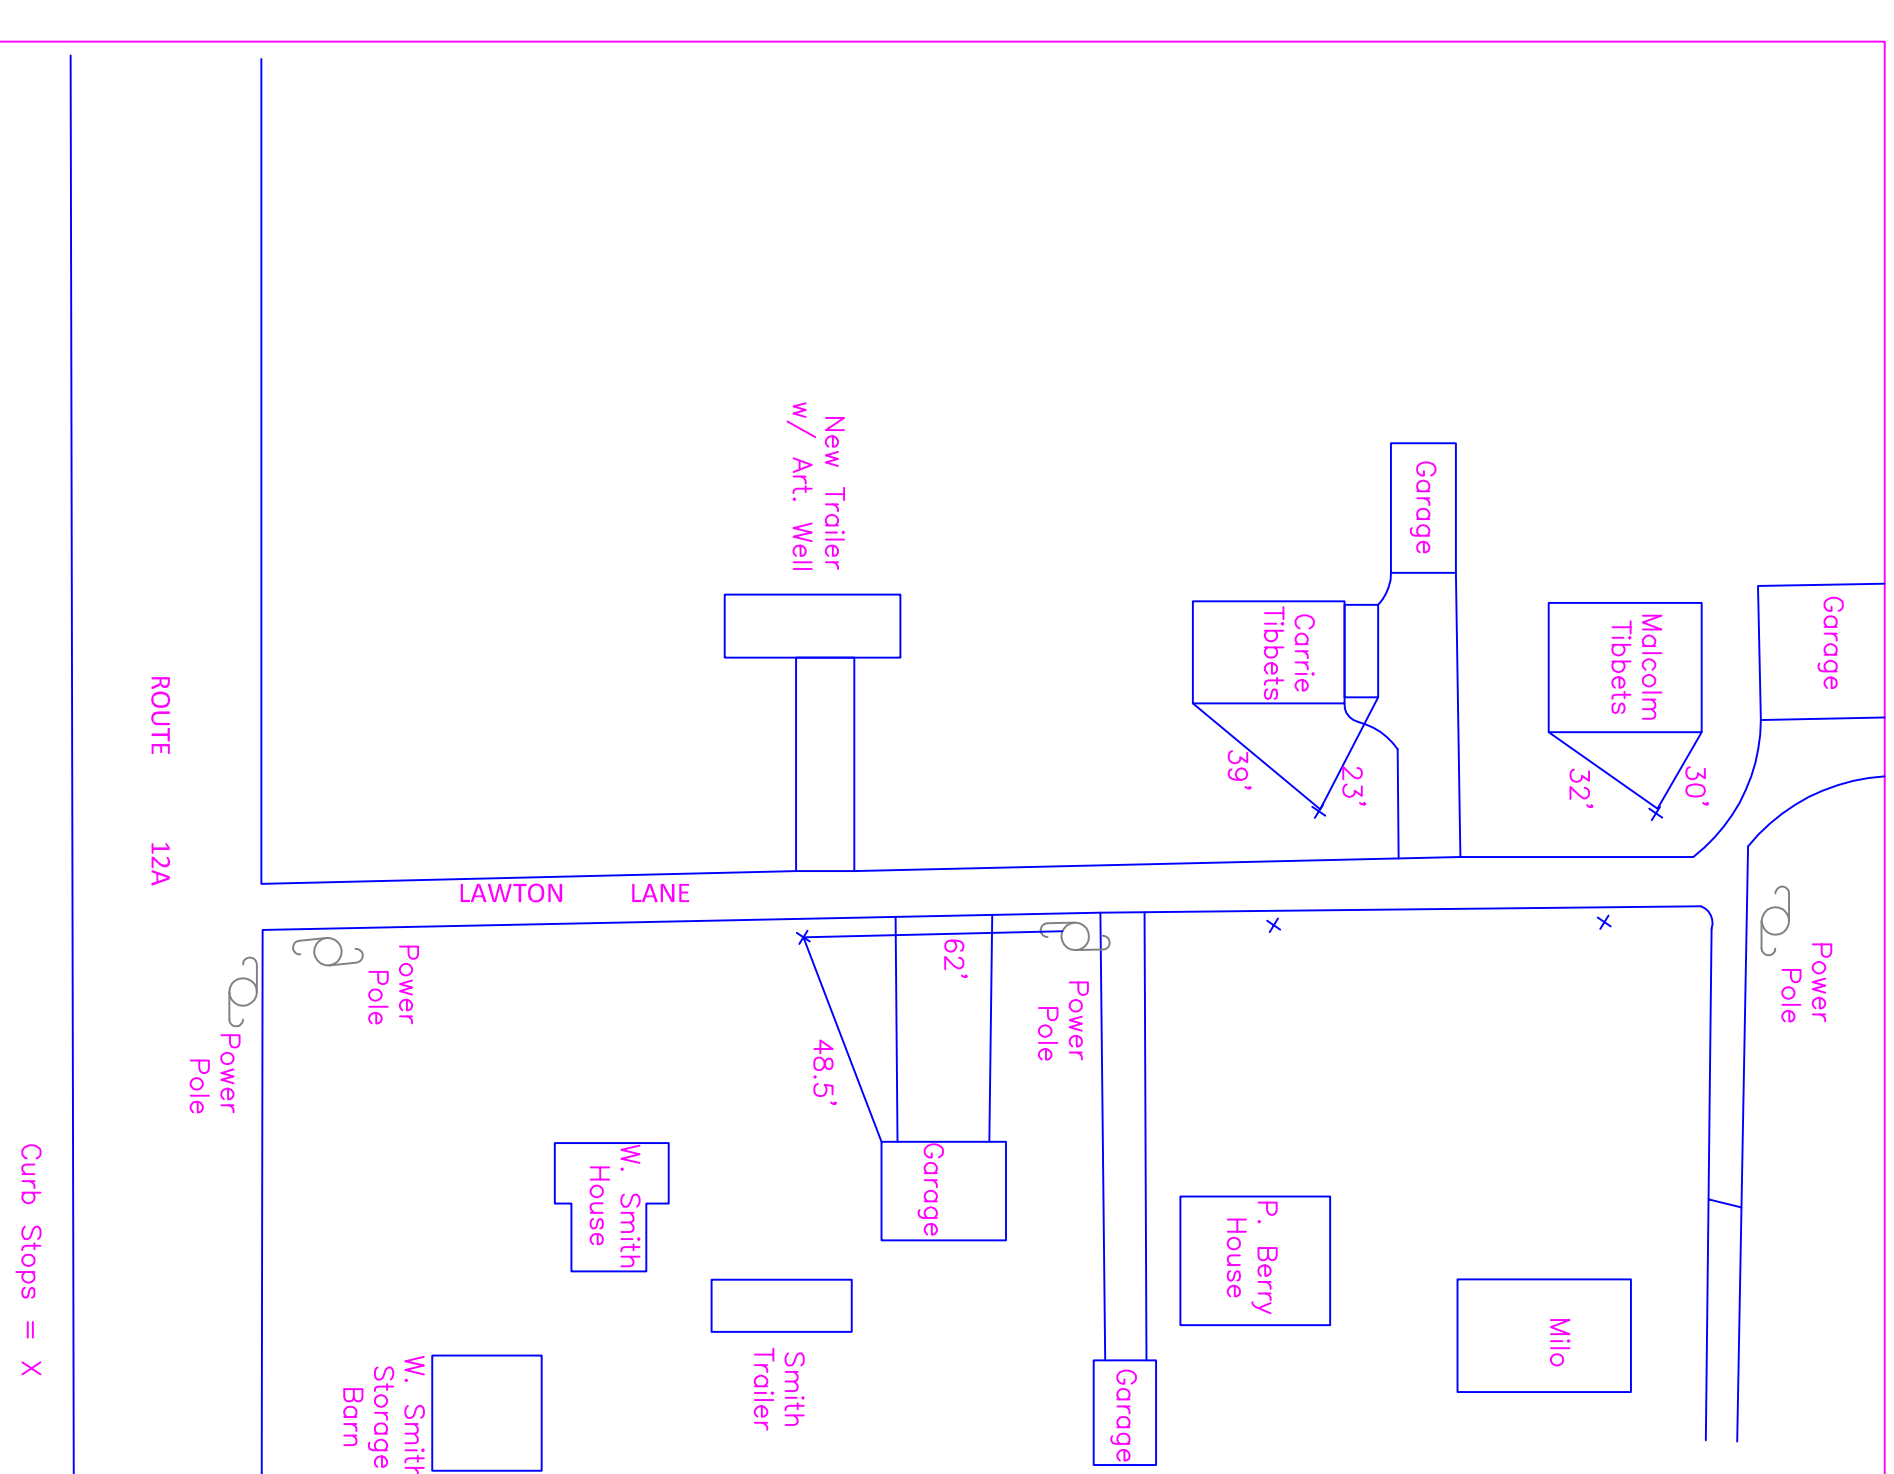


DUFRESNE GROUP
CONSULTING ENGINEERS
 54 Main Street, P.O. Box B
 Windsor, Vermont 05089
 E-mail: dufresne@vermont.net
 Web: www.dufresnegroup.com
 Windsor, VT • Tel: (802) 674-2904 Fax: (802) 674-2913
 Barn, VT • Tel: (802) 479-3898 Fax: (802) 479-2851
 St. Johnsbury, VT • Tel: (802) 748-8605 Fax: (802) 748-4512
 Dufresne Group is owned by Dufresne & Associates, PC

REVISIONS		BY
DATE	COMMENTS	

THIS DRAWING SHALL NOT BE REUSED OR ALTERED IN ANY WAY WITHOUT THE WRITTEN APPROVAL AND AUTHORITY OF DUFRESNE GROUP. ANY REVISIONS SHALL BE MADE BY DUFRESNE GROUP. ©

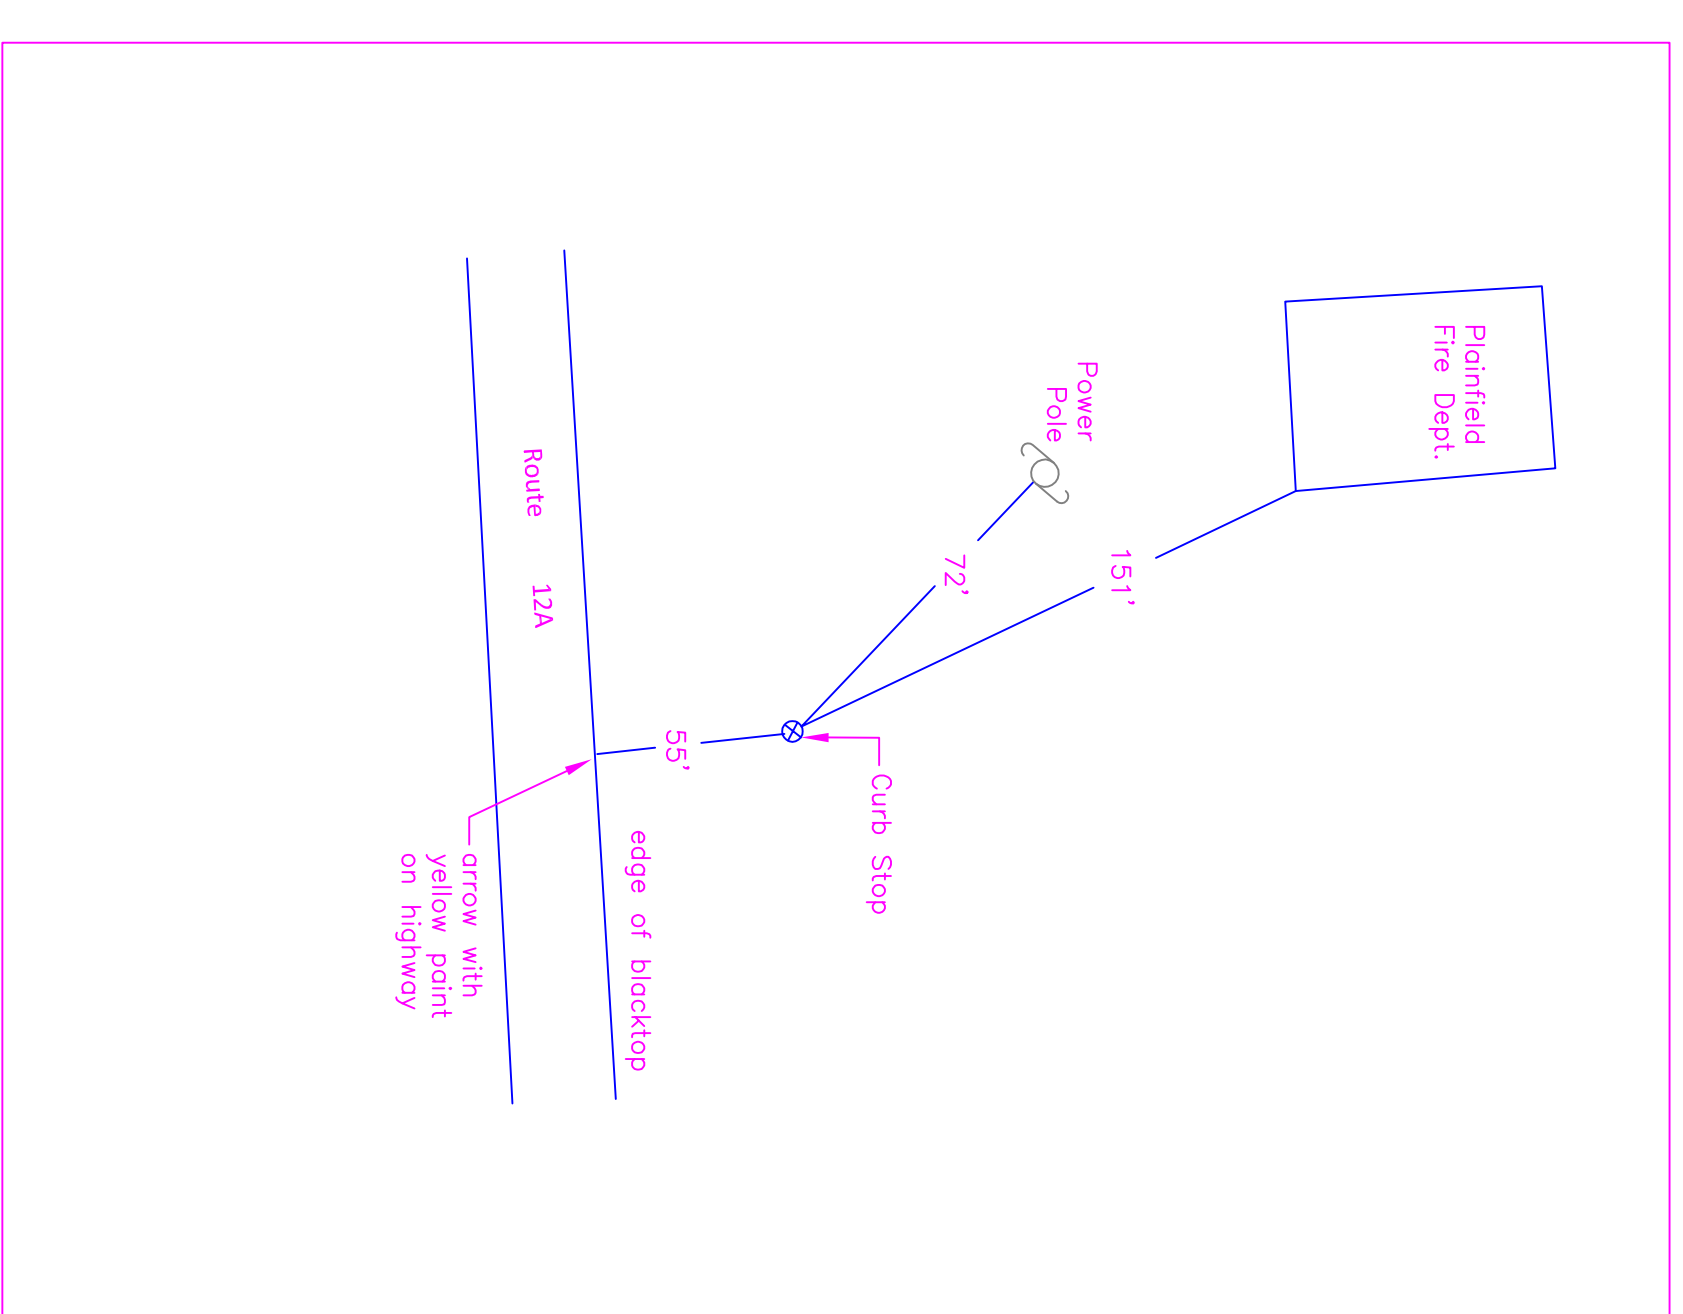

PLAINFIELD VILLAGE
 WATER DISTRICT

MISC. WATER TIES

PLAINFIELD, NEW HAMPSHIRE

Project #	
Project Mgr.	
Design by	O.P.
Drawn by	LMP
Reviewed by	LMP
Approved by	
Date	JUNE 1971
Scale	1" = 500' APPROX.

C5

NOTE:
 THESE AS BUILT RECORD DRAWINGS WERE SCANNED
 AND TRACED USING CIVIL 3D IN MARCH OF 2011.
 NONE OF THE DESIGN WORK WAS PERFORMED BY
 DUFRESNE GROUP.