



**DUFRESNE GROUP**  
 CONSULTING ENGINEERS  
 54 Main Street, P.O. Box B  
 Windsor, Vermont 05089  
 E-mail: [adufresne@vermontdug.com](mailto:adufresne@vermontdug.com)  
 Web: [www.dufresnegroup.com](http://www.dufresnegroup.com)  
 Windsor, VT • Tel: (802) 674-2904 Fax: (802) 674-2913  
 Barre, VT • Tel: (802) 479-3888 Fax: (802) 479-2881  
 St. Johnsbury, VT • Tel: (802) 748-8605 Fax: (802) 748-4912  
 Dufresne Group is a member of the Dufresne & Associates, PC

REVISIONS	
DATE	COMMENTS


**PLAINFIELD VILLAGE WATER DISTRICT**

**WATER MAIN PLAN**

PLAINFIELD, NEW HAMPSHIRE

Project #	
Project Mgr.	
Design by	O.P.
Drawn by	LMP
Reviewed by	LMP
Approved by	
Date	JUNE 1971
Scale	1" = 500' APPROX.

SHEET 2 OF 4

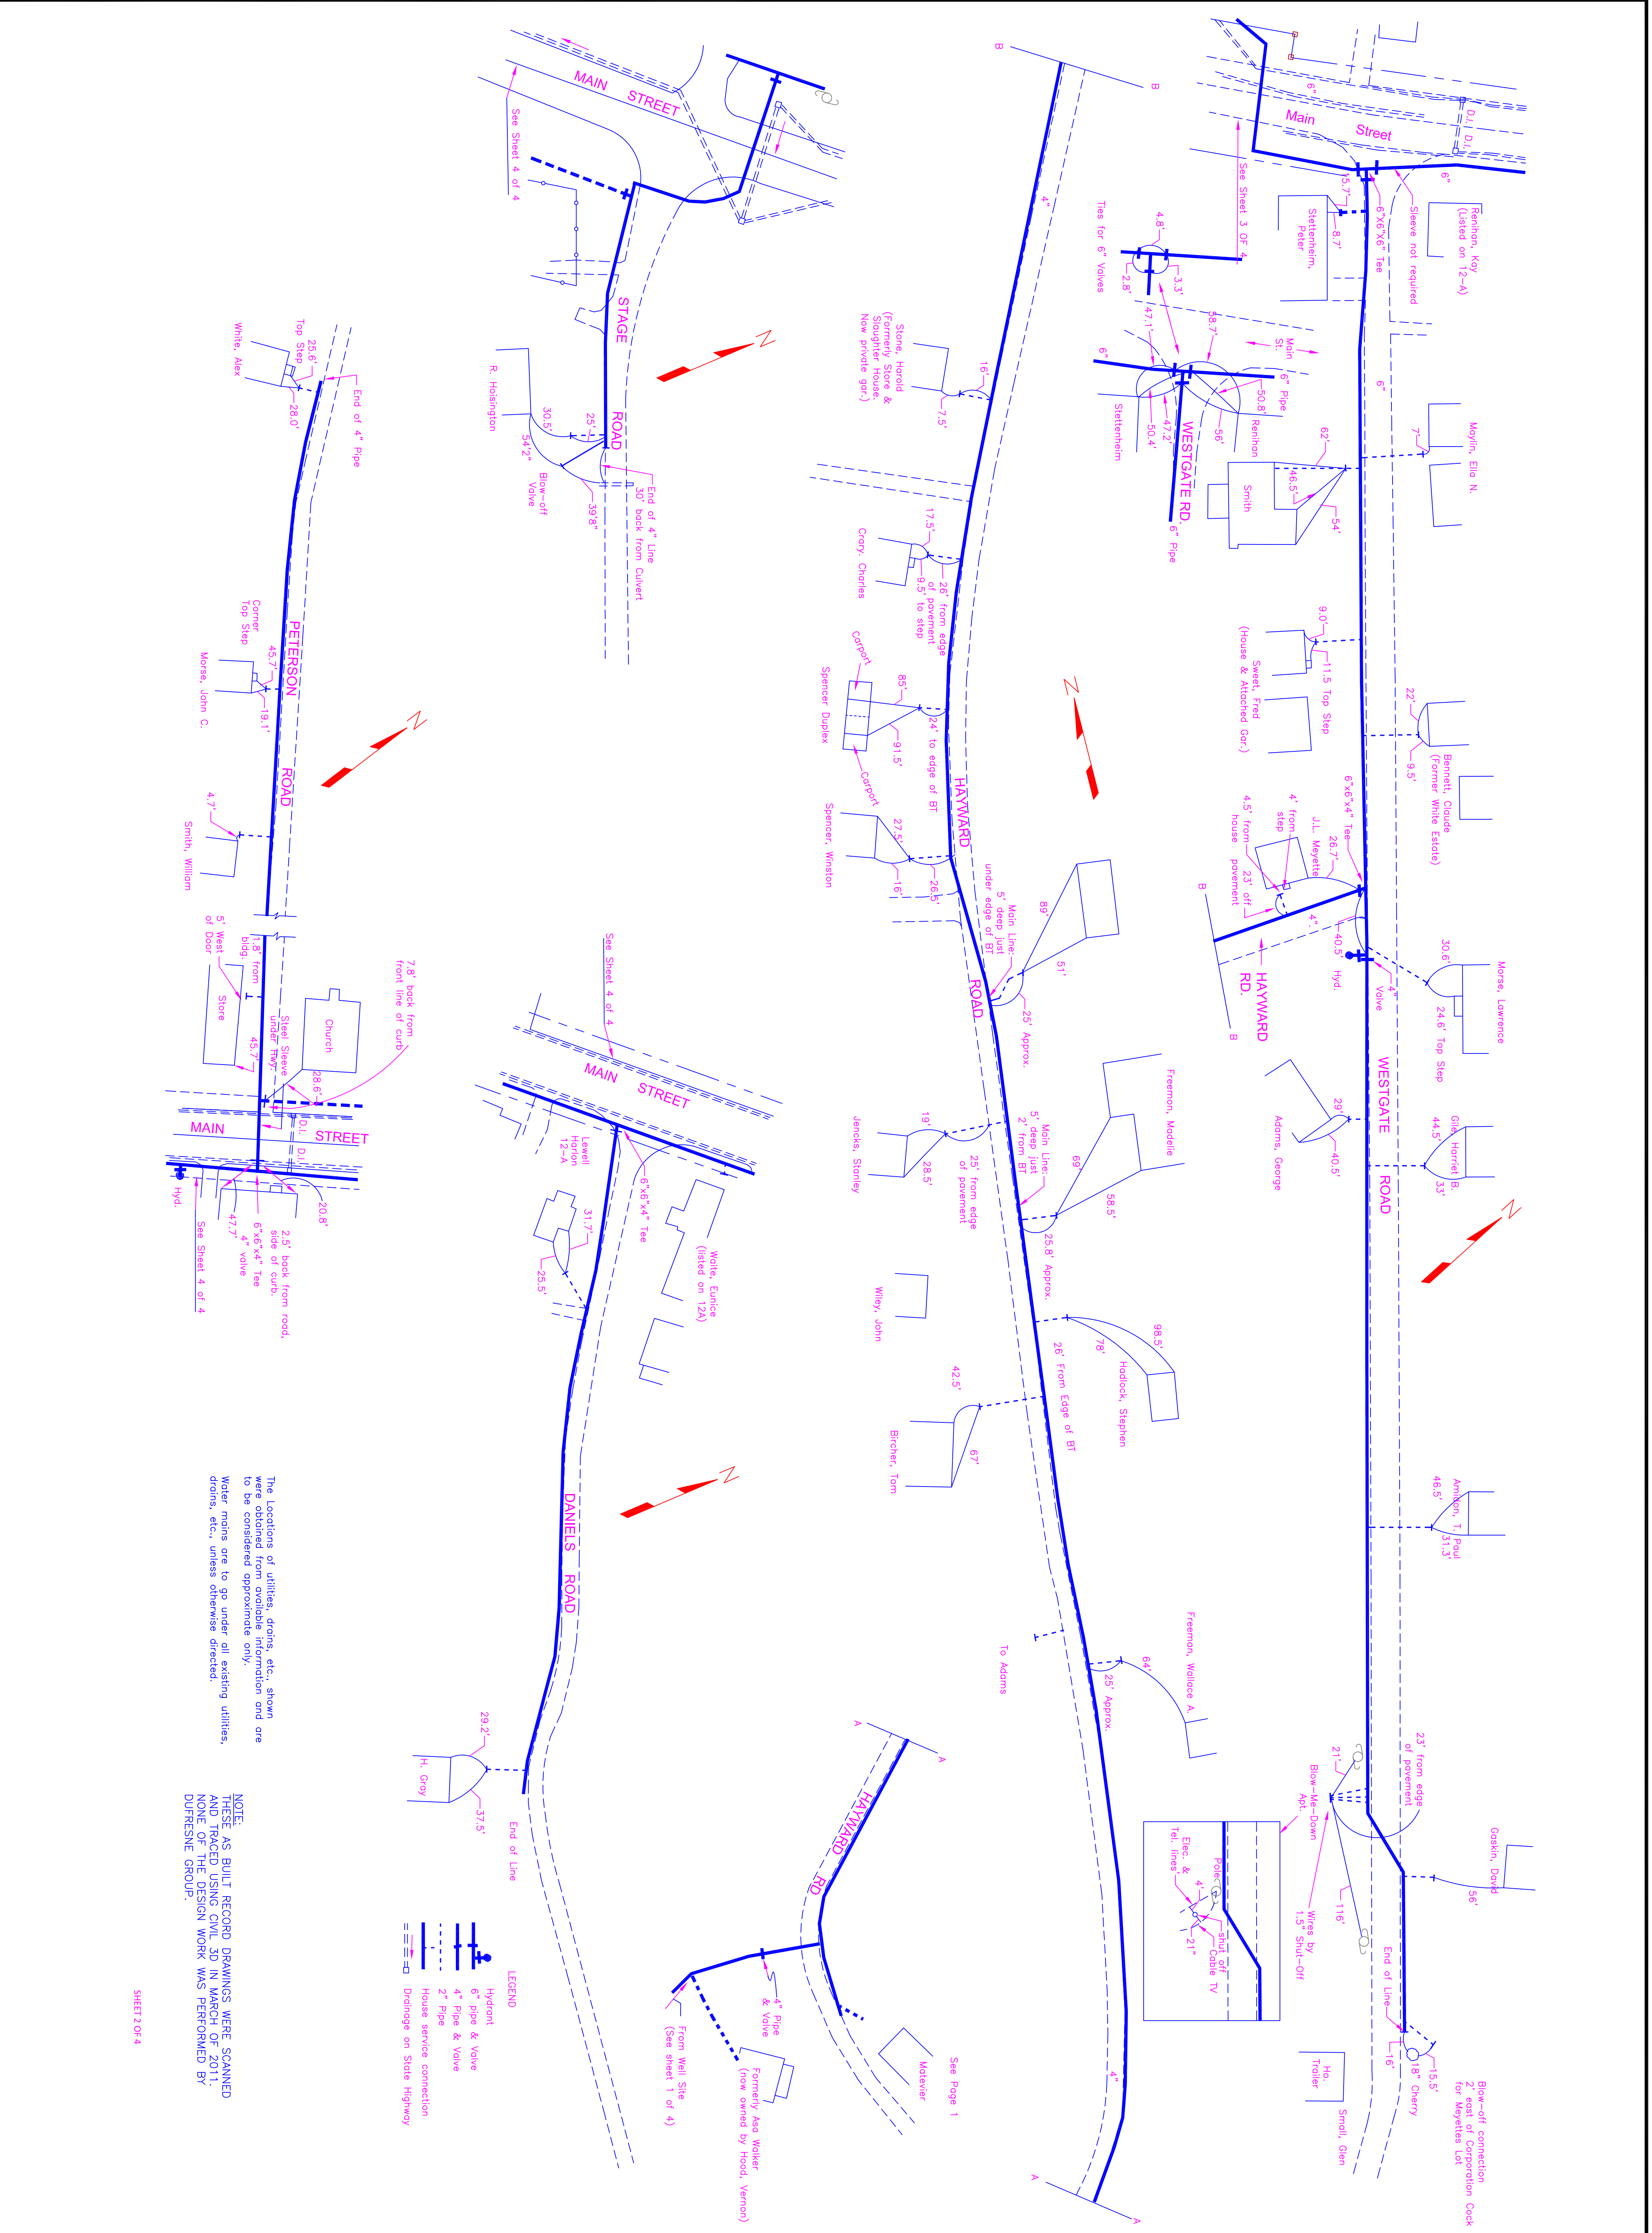

The Locations of utilities, drains, etc., shown were obtained from available information and are to be considered approximate only.

Water mains are to go under all existing utilities, drains, etc., unless otherwise directed.

NOTE:  
 THESE AS-BUILT RECORD DRAWINGS WERE SCANNED AND TRACED USING CIVIL 3D IN MARCH OF 2011.  
 NONE OF THE DESIGN WORK WAS PERFORMED BY DUFRESNE GROUP.

SHEET 2 OF 4