




**DUFRESNE GROUP**  
**CONSULTING ENGINEERS**  
 54 Main Street, P.O. Box B  
 Windsor, Vermont 05089  
 E-mail: [info@dufresne.com](mailto:info@dufresne.com)  
 Web: [www.dufresne.com](http://www.dufresne.com)  
 Windsor, VT • Tel: (802) 674-2904 Fax: (802) 674-2913  
 Barre, VT • Tel: (802) 479-3898 Fax: (802) 479-2851  
 St. Johnsbury, VT • Tel: (802) 748-8605 Fax: (802) 748-4912  
 Dufresne Group is licensed by Dufresne & Associates, PC

DATE	COMMENTS	BY

THIS DRAWING SHALL NOT BE REUSED OR ALTERED IN ANY WAY WITHOUT THE WRITTEN APPROVAL AND AUTHORITY OF DUFRESNE GROUP. ANY REVISIONS SHALL BE MADE BY DUFRESNE GROUP. ©

PLAINFIELD VILLAGE  
 WATER MAIN PLAN  
 PLAINFIELD, NEW HAMPSHIRE

Project #	
Project Mgr.	
Design by	O.P.
Drawn by	LMP
Reviewed by	LMP
Approved by	
Date	JUNE 1971
Scale	1" = 500' APPROX.

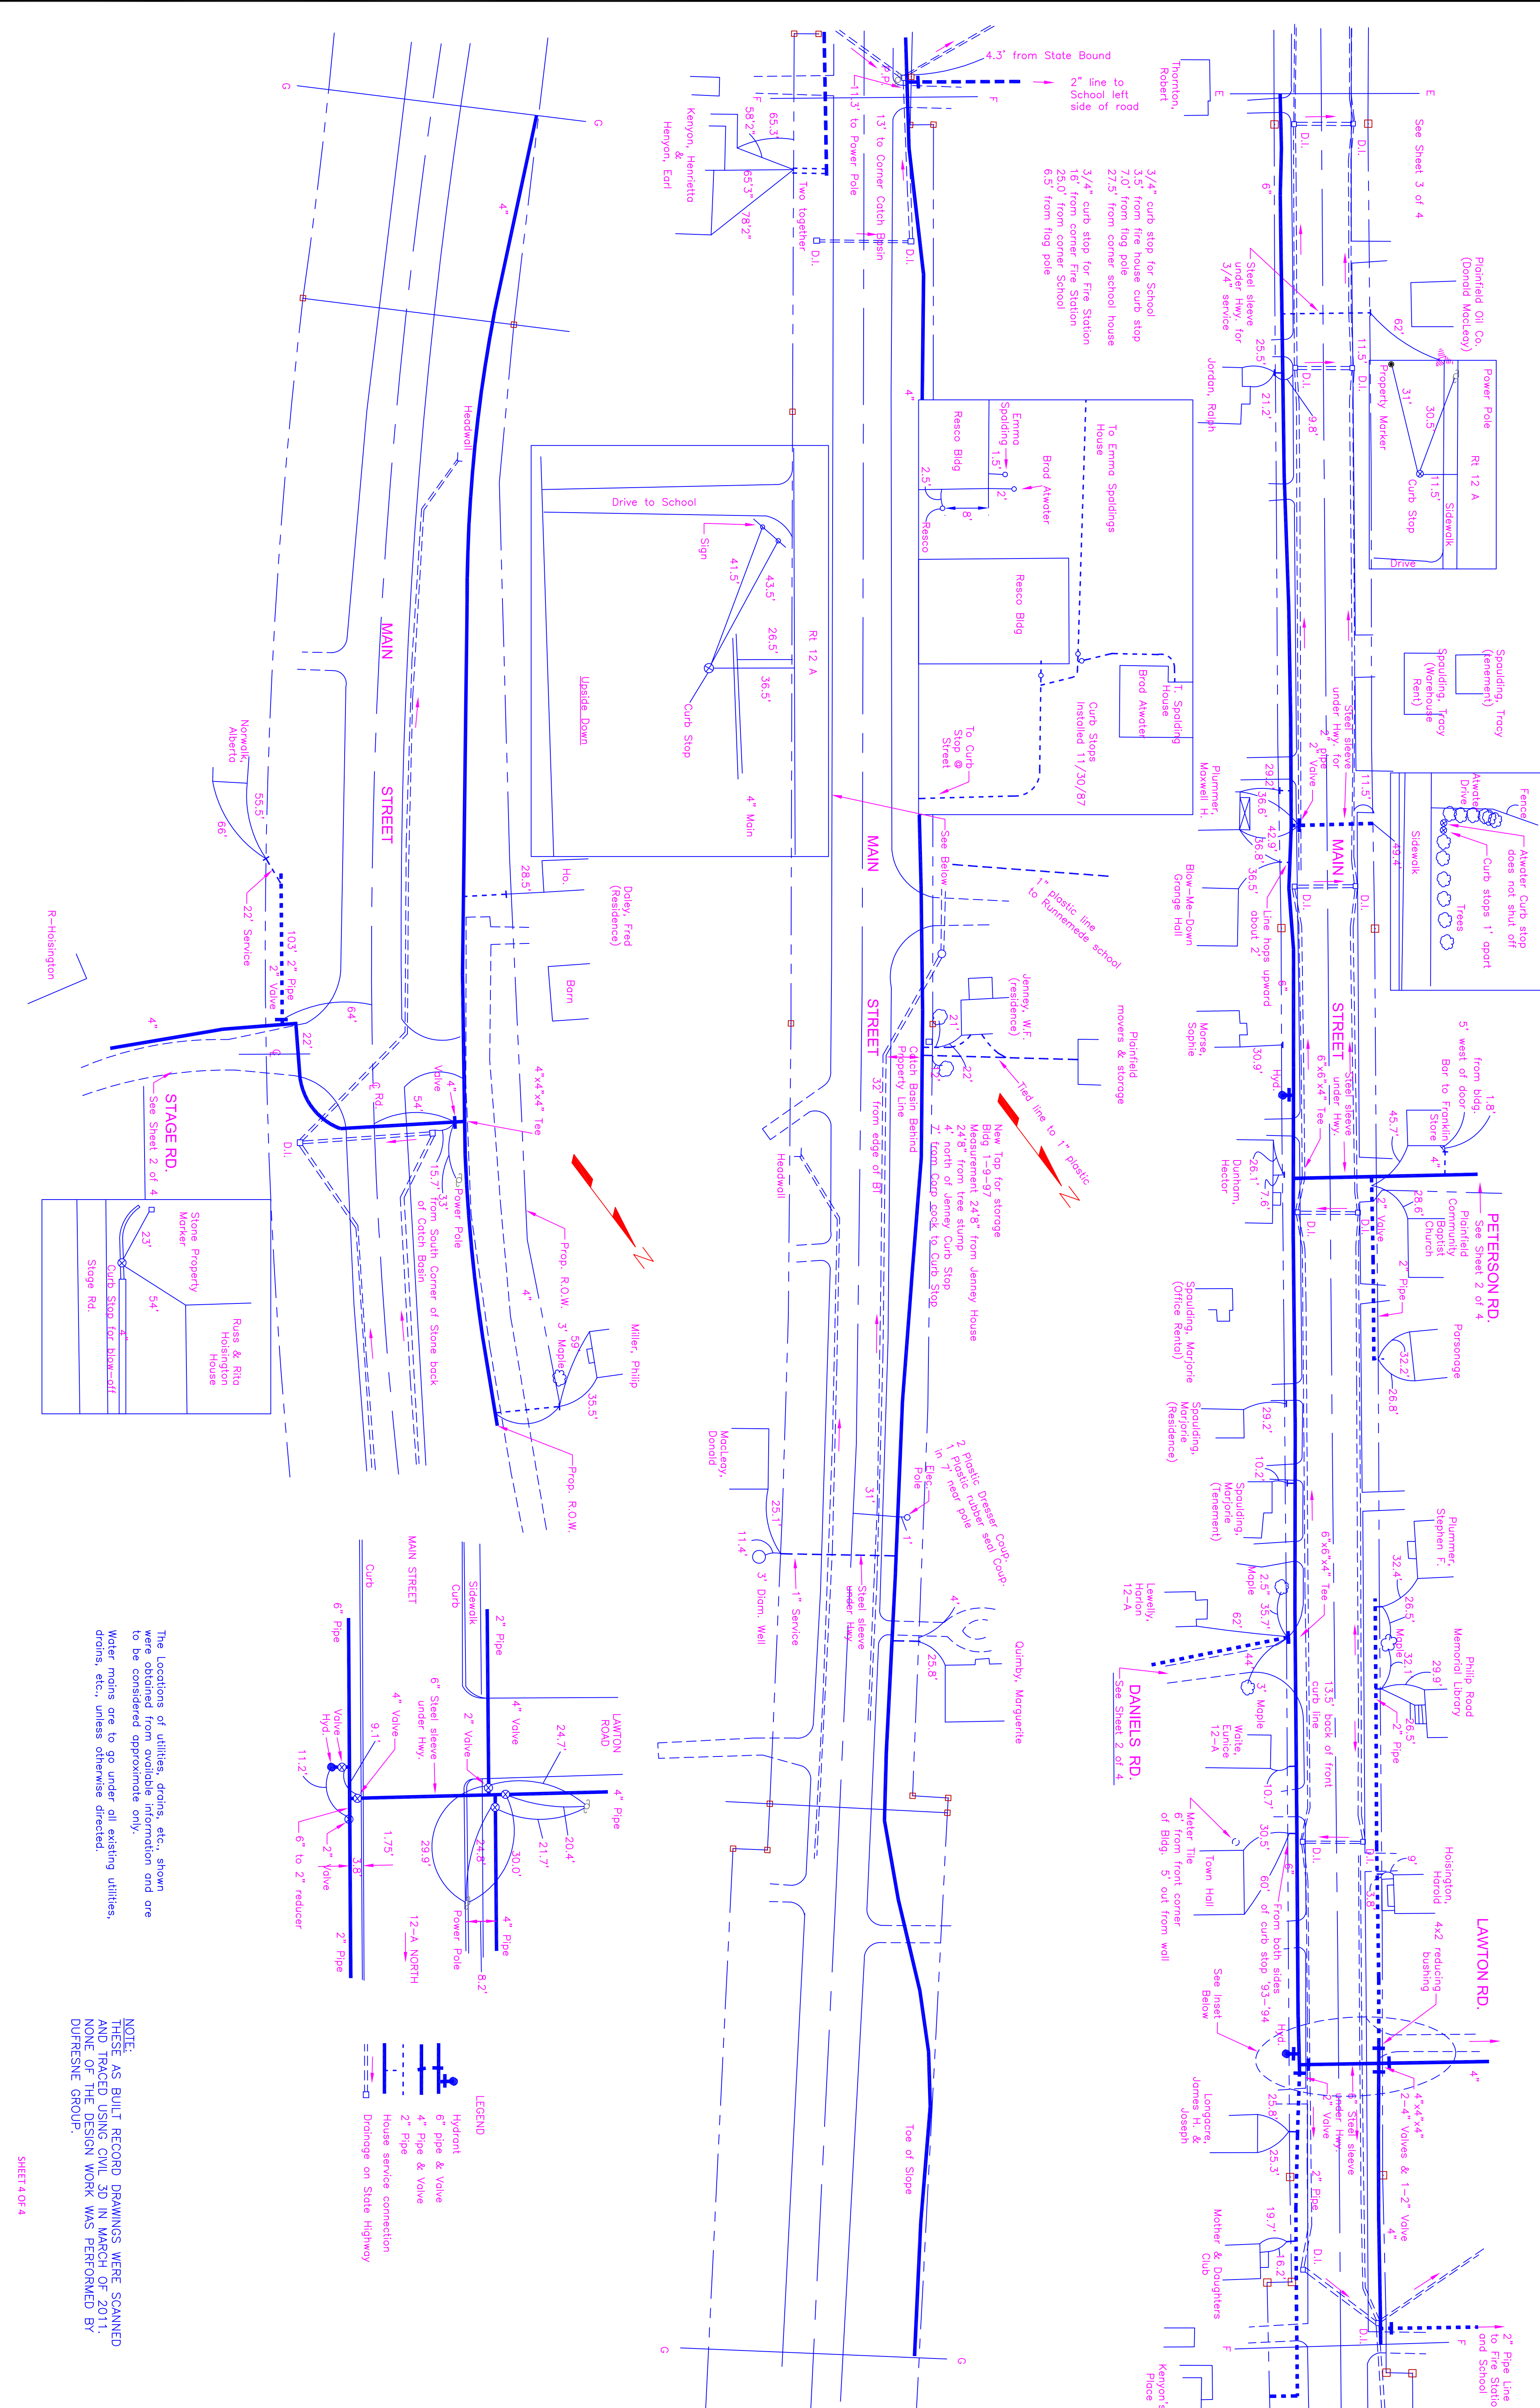

NOTE:  
 THESE AS BUILT RECORD DRAWINGS WERE SCANNED  
 AND TRACED USING CIVIL 3D IN MARCH OF 2011.  
 NONE OF THE DESIGN WORK WAS PERFORMED BY  
 DUFRESNE GROUP.

SHEET 4 OF 4