




DUFRESNE GROUP CONSULTING ENGINEERS

54 Main Street, P.O. Box B Windsor, Vermont 05089 E-mail: dufresne@vermontel.net Web: www.dufresnegroup.com

Windsor, VT • Tel: (802) 674-2904 Fax: (802) 674-2913 Barre, VT • Tel: (802) 479-3698 Fax: (802) 479-2261 St. Johnsbury, VT • Tel: (802) 748-8605 Fax: (802) 748-4512 Dufresne Group is owned by Dufresne & Associates, PC

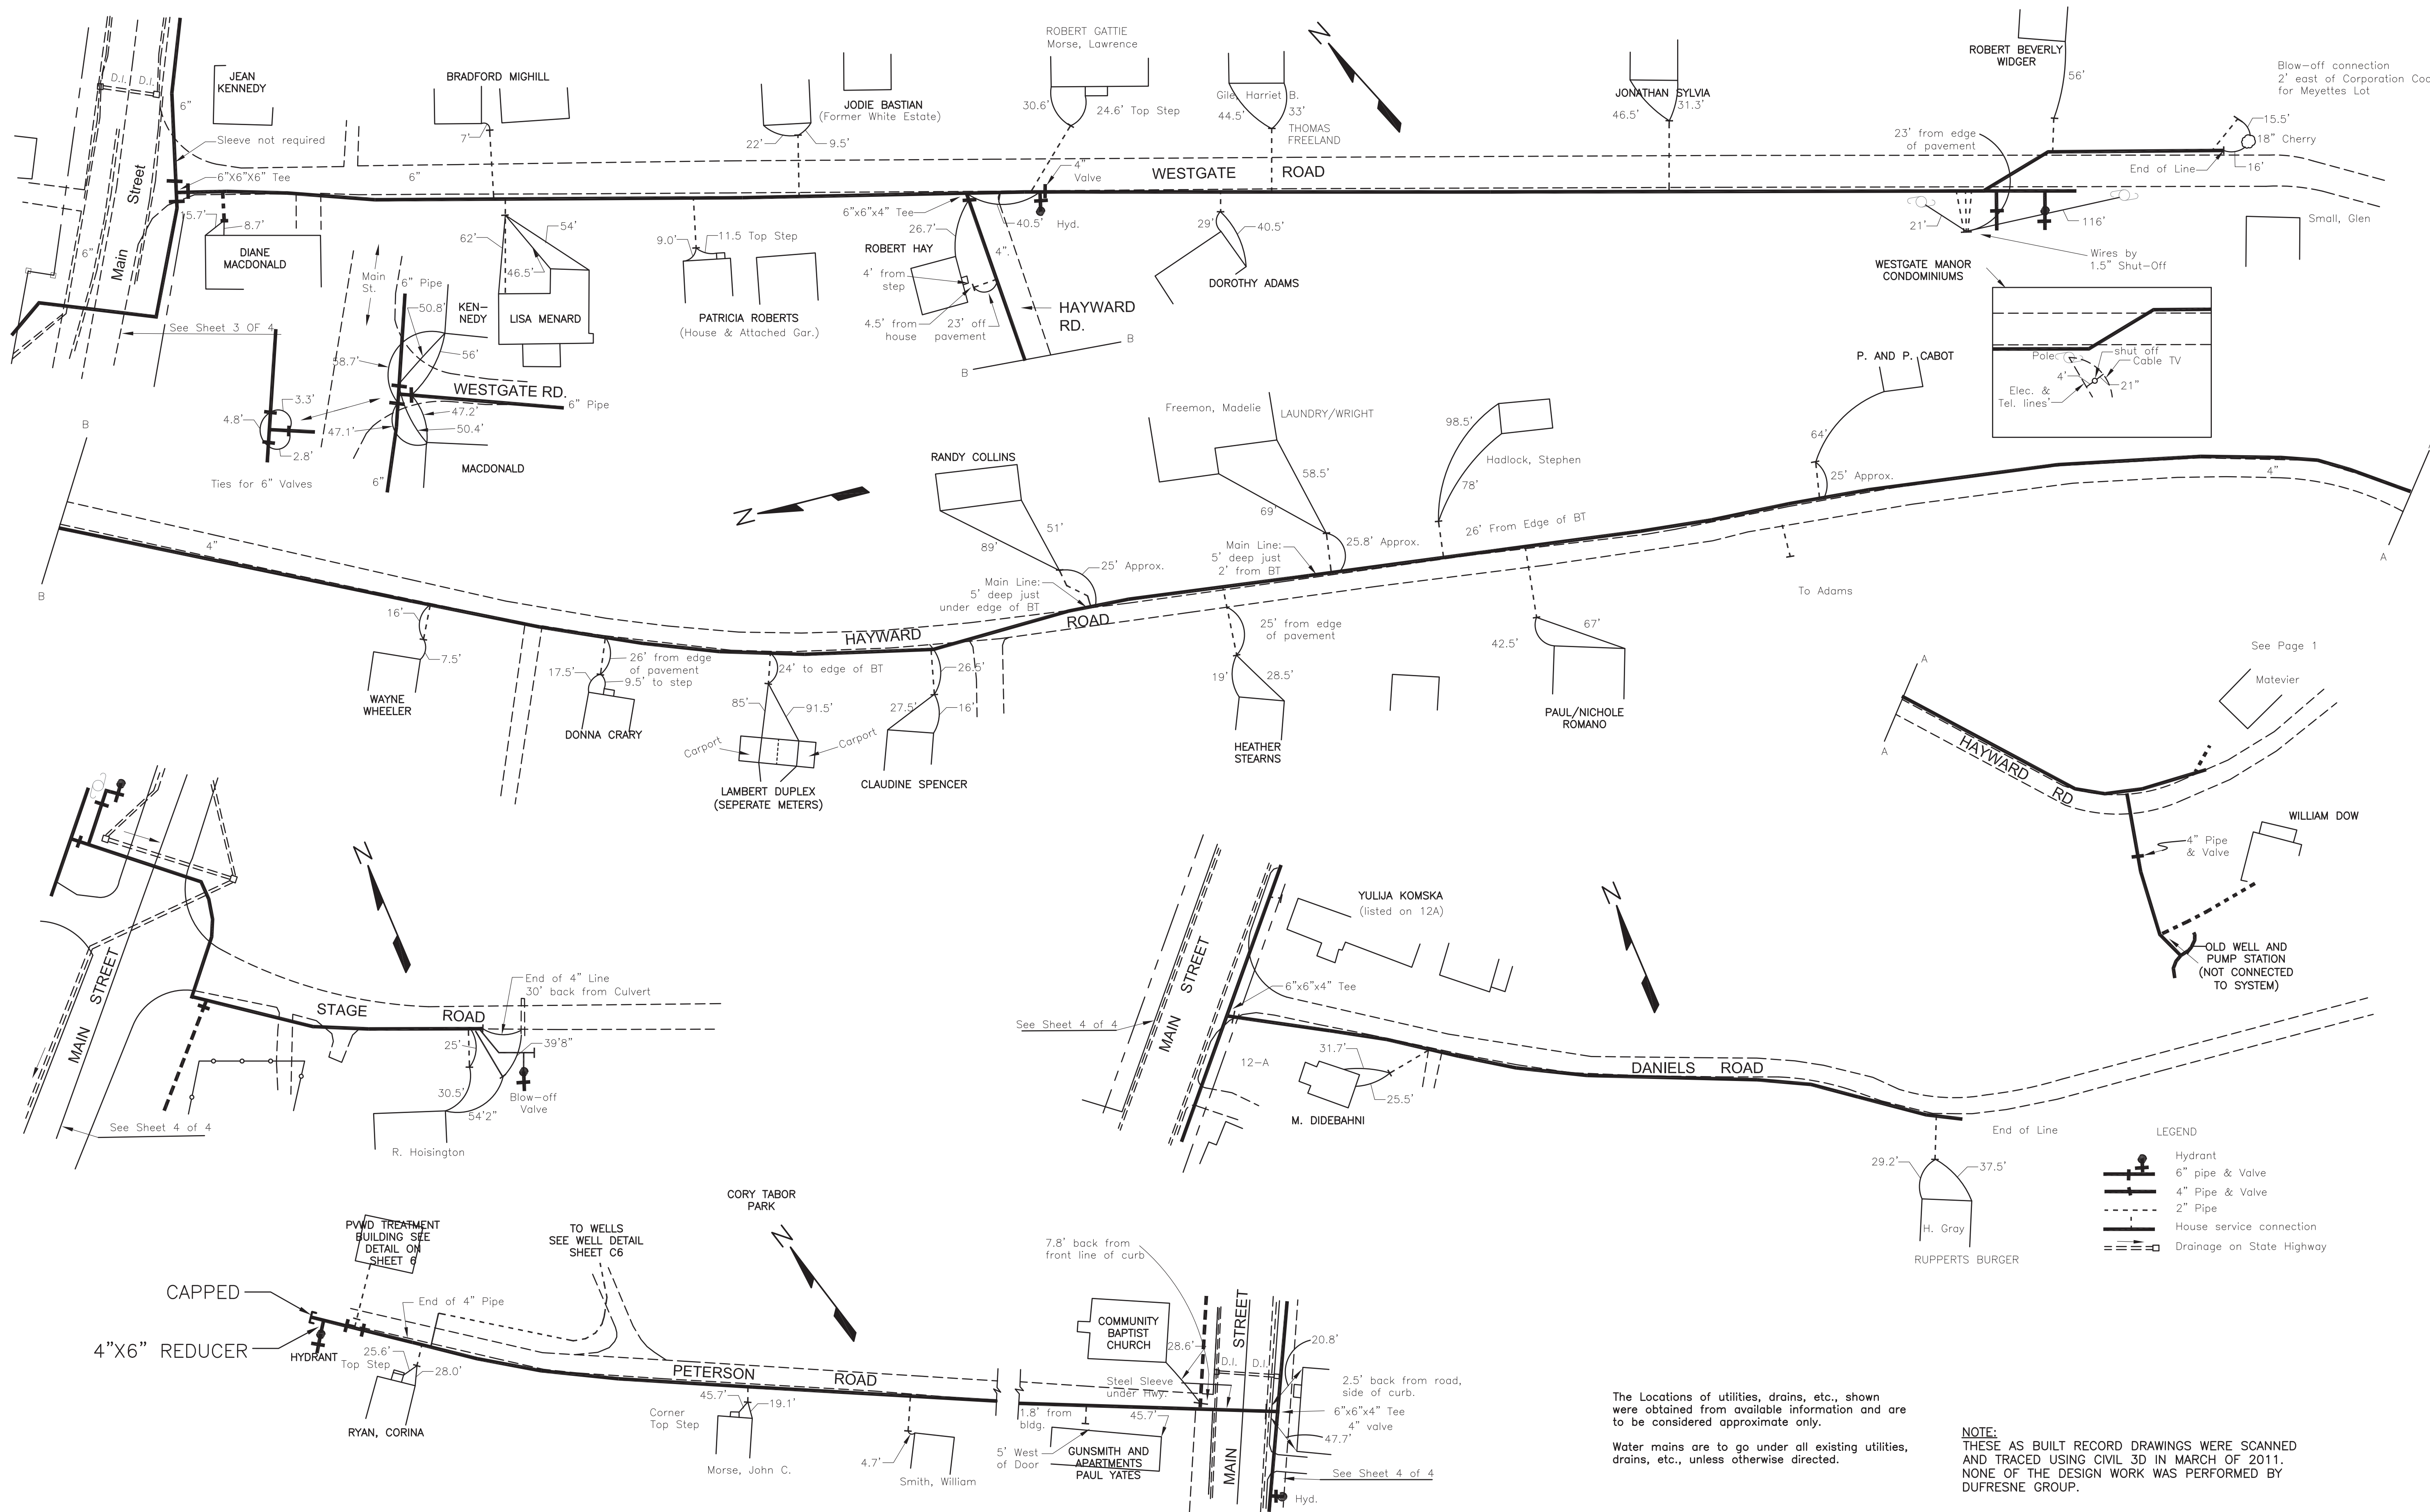

REVISIONS	DATE	COMMENTS	BY

PLAINFIELD VILLAGE WATER DISTRICT WATER MAIN PLAN PLAINFIELD, NEW HAMPSHIRE

LEGEND

- Hydrant
- 6" pipe & Valve
- 4" Pipe & Valve
- 2" Pipe
- House service connection
- Drainage on State Highway

The Locations of utilities, drains, etc., shown were obtained from available information and are to be considered approximate only.

Water mains are to go under all existing utilities, drains, etc., unless otherwise directed.

NOTE: THESE AS BUILT RECORD DRAWINGS WERE SCANNED AND TRACED USING CIVIL 3D IN MARCH OF 2011. NONE OF THE DESIGN WORK WAS PERFORMED BY DUFRESNE GROUP.

Project #	
Project Mgr.	
Design by	
Drawn by	O.P.
Reviewed by	LMP
Approved by	LMP
Date	JUNE 1971
Scale	1" = 500' APPROX.

C2

FILE: P:\CAD00_Plan\Drawings\Water\Main\Bachel\Water\Bachel.dwg, Feb 25, 2014 - 10:09am