

Rec'd
7-3-19
\$150.00
mmayf

TOWN OF PLAINFIELD ZONING AND BUILDING PERMIT APPLICATION



Property Owner:

Name: Phone:

Street: Email:

City State Zip:

Project: Permit Type: (Check one) Building Zoning

Street Address:

Tax Map: Lot Number: Lot Acreage: Zoning District:

Proposed project distances to property lines (in feet): Front: Rear: Side: Side:

State Approved Septic Design #: Driveway Permit #:

Please provide a written description of the project including appropriate dimensions:

Contractor Information:

Builder:	Electrician:	Plumber:
Name: <input type="text" value="Larry Davis"/>	Name: <input type="text" value="Eastman Electric"/>	Name: <input type="text"/>
Phone: <input type="text" value="(802) 763-8666"/>	Phone: <input type="text" value="(603) 989-5941"/>	Phone: <input type="text"/>

Applicant Signature: Date:

Required Attachments:

Please provide a copy of plans detailing the project. Hand-drawn plans can be used if necessary. Permits cannot be issued without receipt of the proper fee. If you are unsure of the amount due or have any questions about your application, contact the town office (603-469-3201).

TOWN USE: Current Use: Yes / No ZBA: Yes / No PB: Yes / No


BOARD OF SELECTMEN ACTION

Approved Denied

Permit # Date:


Reviewed by Building Inspector or Zoning Administrator

Perron Garage & Porch Proj.

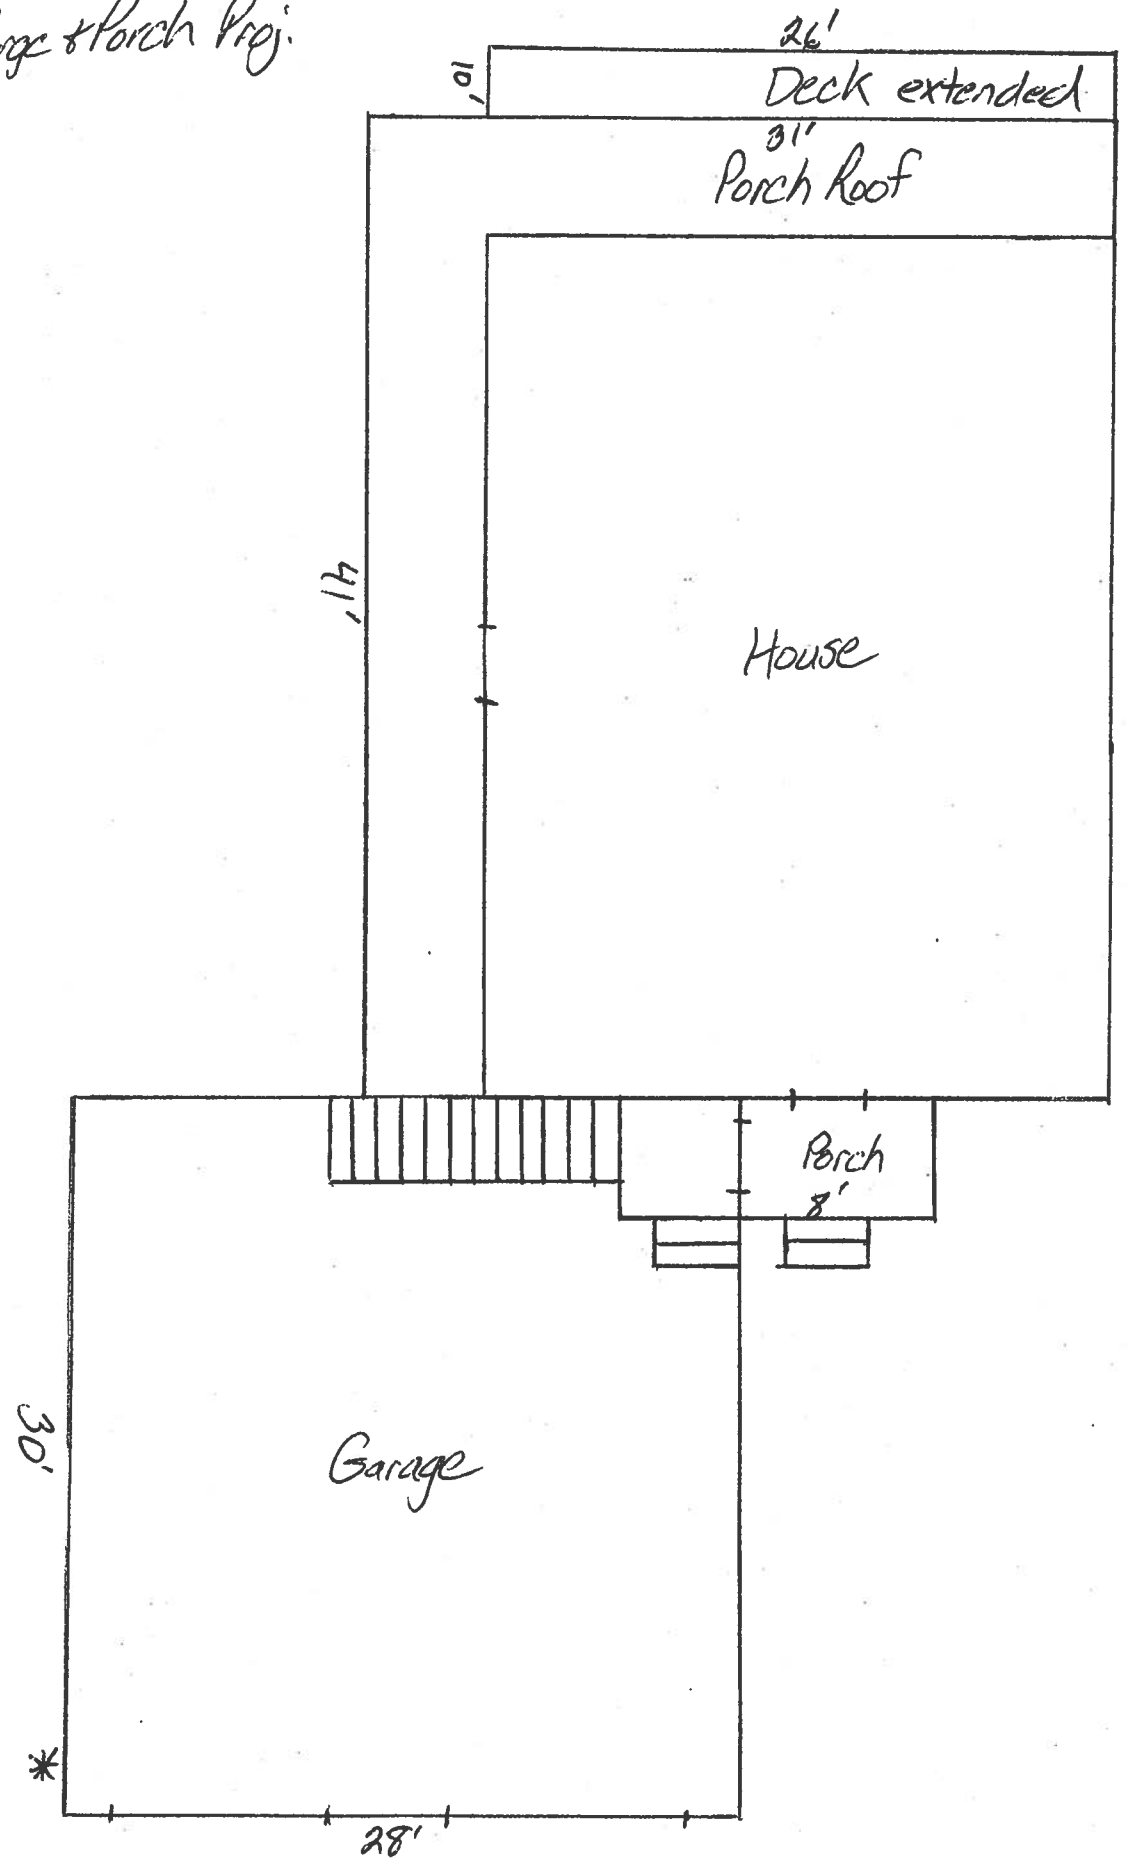


1/8" = 1'


* Location of power meter to be placed on garage

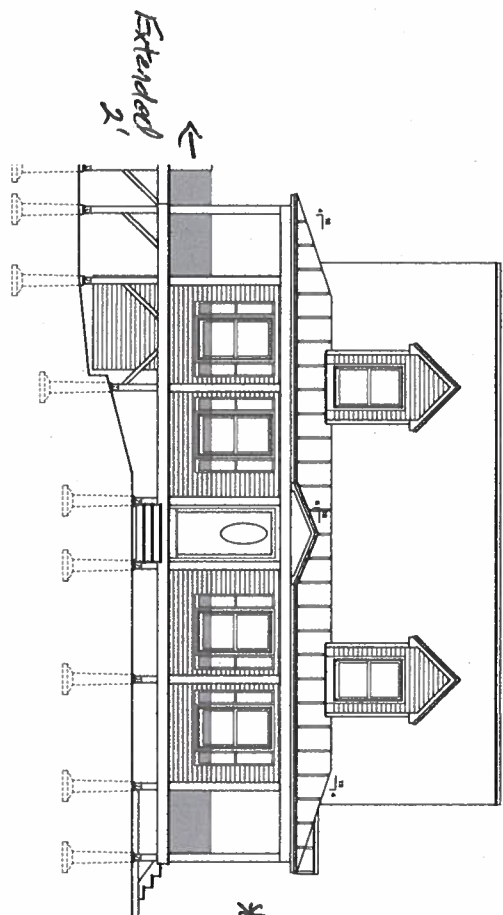


1 PROPOSED FRONT ELEVATION
Scale: 1/8" = 1'-0"

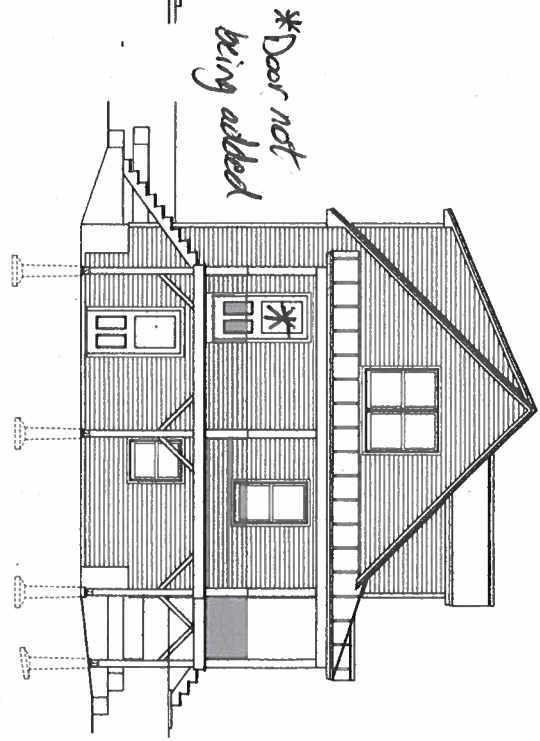

2 PROPOSED REAR ELEVATION
Scale: 1/8" = 1'-0"

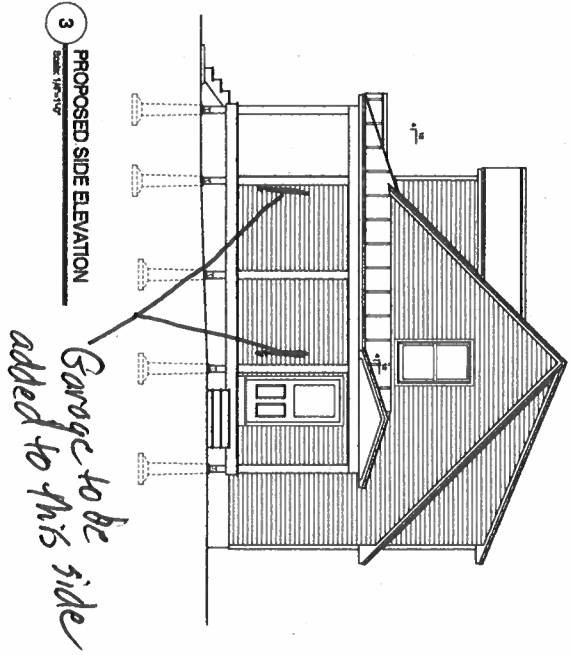

3 PROPOSED SIDE ELEVATION
Scale: 1/8" = 1'-0"

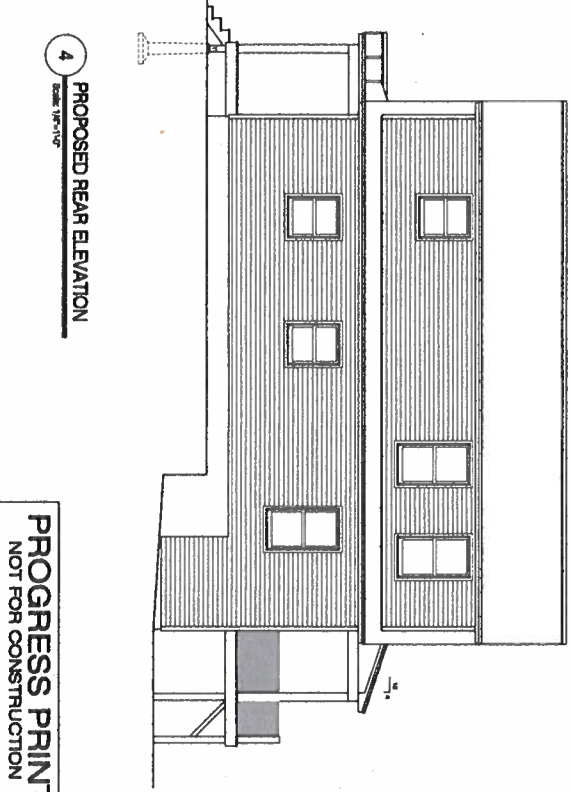

4 PROPOSED REAR ELEVATION
Scale: 1/8" = 1'-0"

PROGRESS PRINT
NOT FOR CONSTRUCTION

