

building to scale




42'  
BACK  
N. CORNER  
TO BACK  
PROPERTY

54'  
FRONT  
N. CORNER  
TO FRONT  
ROAD

PLAINFIELD, NH GIS

1" = 120'

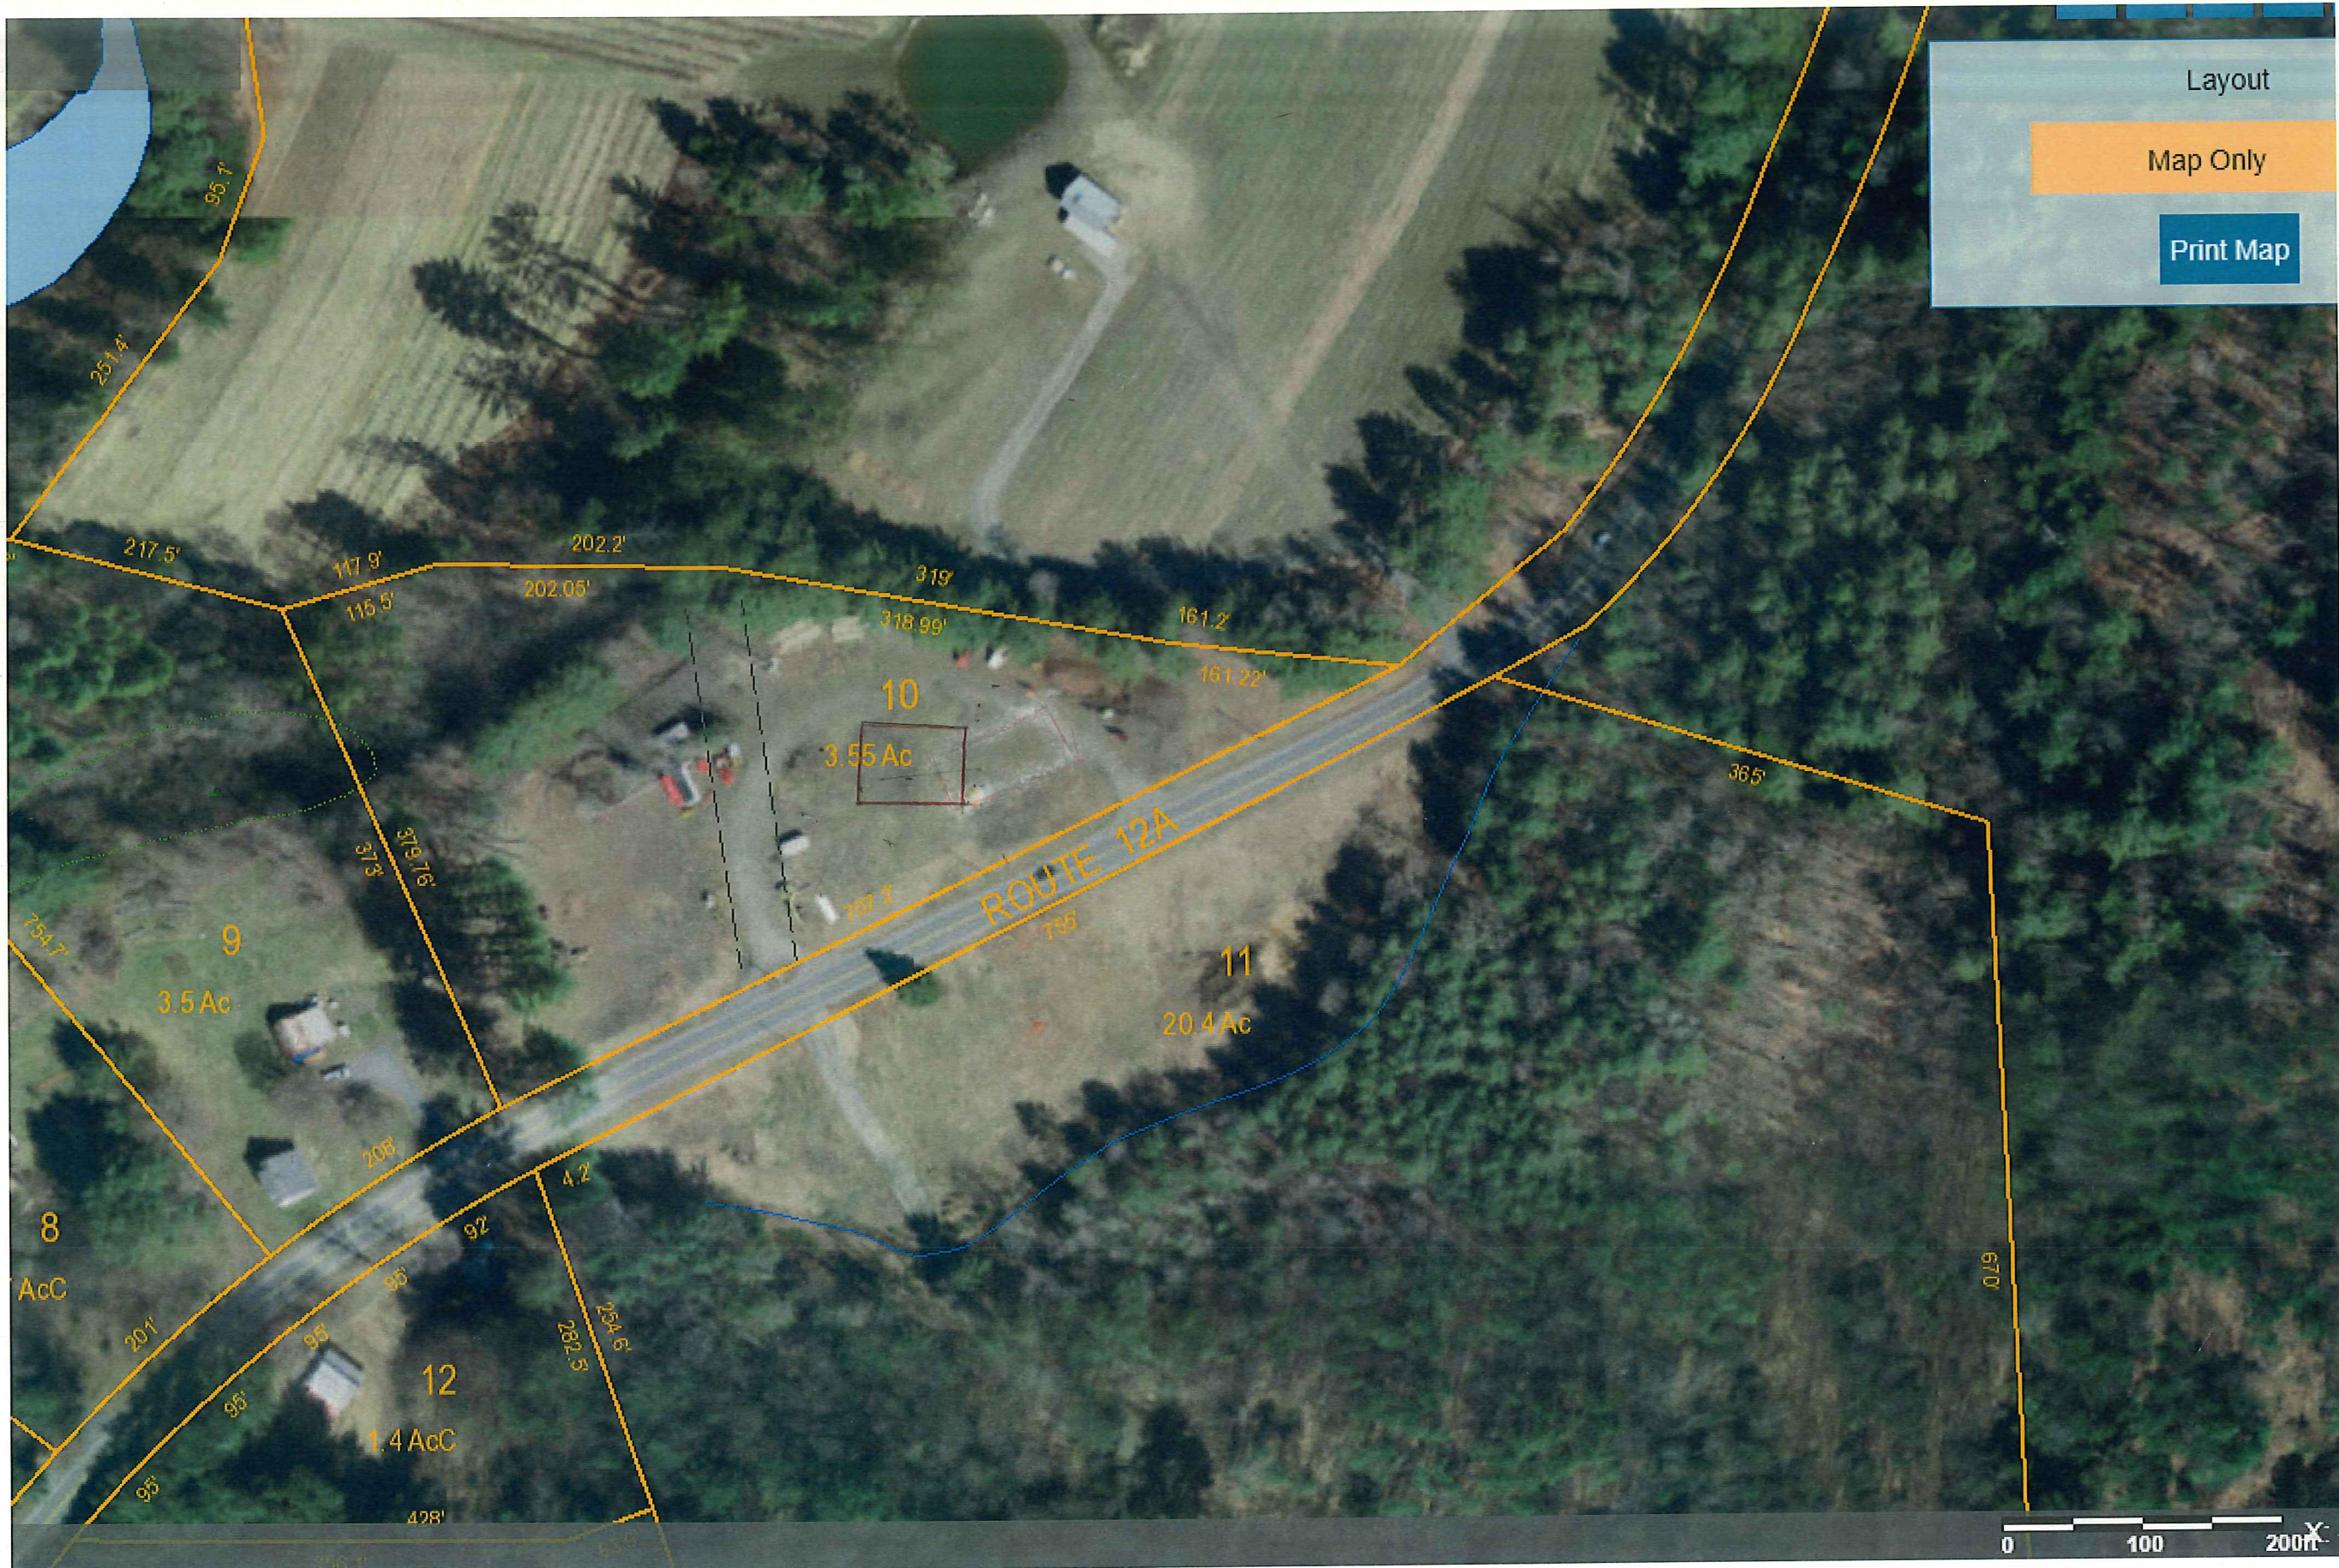

Layout

Map Only

Print Map

42'  
BACK  
N. CORNER  
TO BACK  
PROPERTY

54'  
FRONT  
N. CORNER  
TO FRONT  
ROAD

PLAINFIELD, NH GIS

1" = 120'